

	ALREADY CONSTRUCTED COLUMNS & WALLS NOT REQUIRED TO DEMOLISH
	ALREADY CONSTRUCTED COLUMNS & WALLS REQUIRED TO DEMOLISH & RECONSTRUCTION
	EXISTING COLUMNS & WALLS TO BE DEMOLISHED
	COLUMNS & WALLS TO BE NEWLY BUILD-UP
	SLAB TO BE NEWLY BUILD-UP

PLAN:

PROPOSED BUILDING

IN THE EVENT OF ANY DISCREPANCIES OR DIFFERENCE BETWEEN ANY ARCHITECTURAL DRAWINGS AND STRUCTURAL DRAWINGS OR OTHER ENGINEERING DRAWINGS OR SITE CONDITIONS OR OTHERWISE IMMEDIATE REFERENCE IS TO BE MADE TO THE ARCHITECT FOR CLARIFICATION PRIOR TO EXECUTION OF WORK AT SITE

PROPOSED
REFURBISHMENT
BUILDING



**PREMIER ENTRANCE
TECHNOLOGIES (PVT)LTD,**
No. 159/7/A,
KOSGAHENA JUNCTION,
PANNIPITIYA.
Tel : +94 112 851 729
Mobile : +94 713 270 996 /
+94 778 144 551
Web : www.premierentrance.com
Email : info@premierentrance.com

- ☐ A-APPROVED
☐ B-APPROVED AS COMMENTED
☐ C-REVISE & RESUBMIT
☐ D-FOR INFORMATION

AUTHORIZED SIGNATURE

DATE :

△	-	-
△	-	-
REV. NO.	BRIEF DESCRIPTION	DATE

REFERENCE DRAWINGS


-	-
-	-
-	-
-	-

DRAWING TITLE:
**PROPOSED LAYOUT
BASEMENT FLOOR**

SHOP DRAWINGS

Scale: AS SHOWN A3	Drawn by: SANDUN	Checked by: PET	Approved by: CLIENT
-----------------------	---------------------	--------------------	------------------------

DATE :	DRAWING NO.:	REV.
13-06-2026	PET-AR-SPD-2026-08-01	0

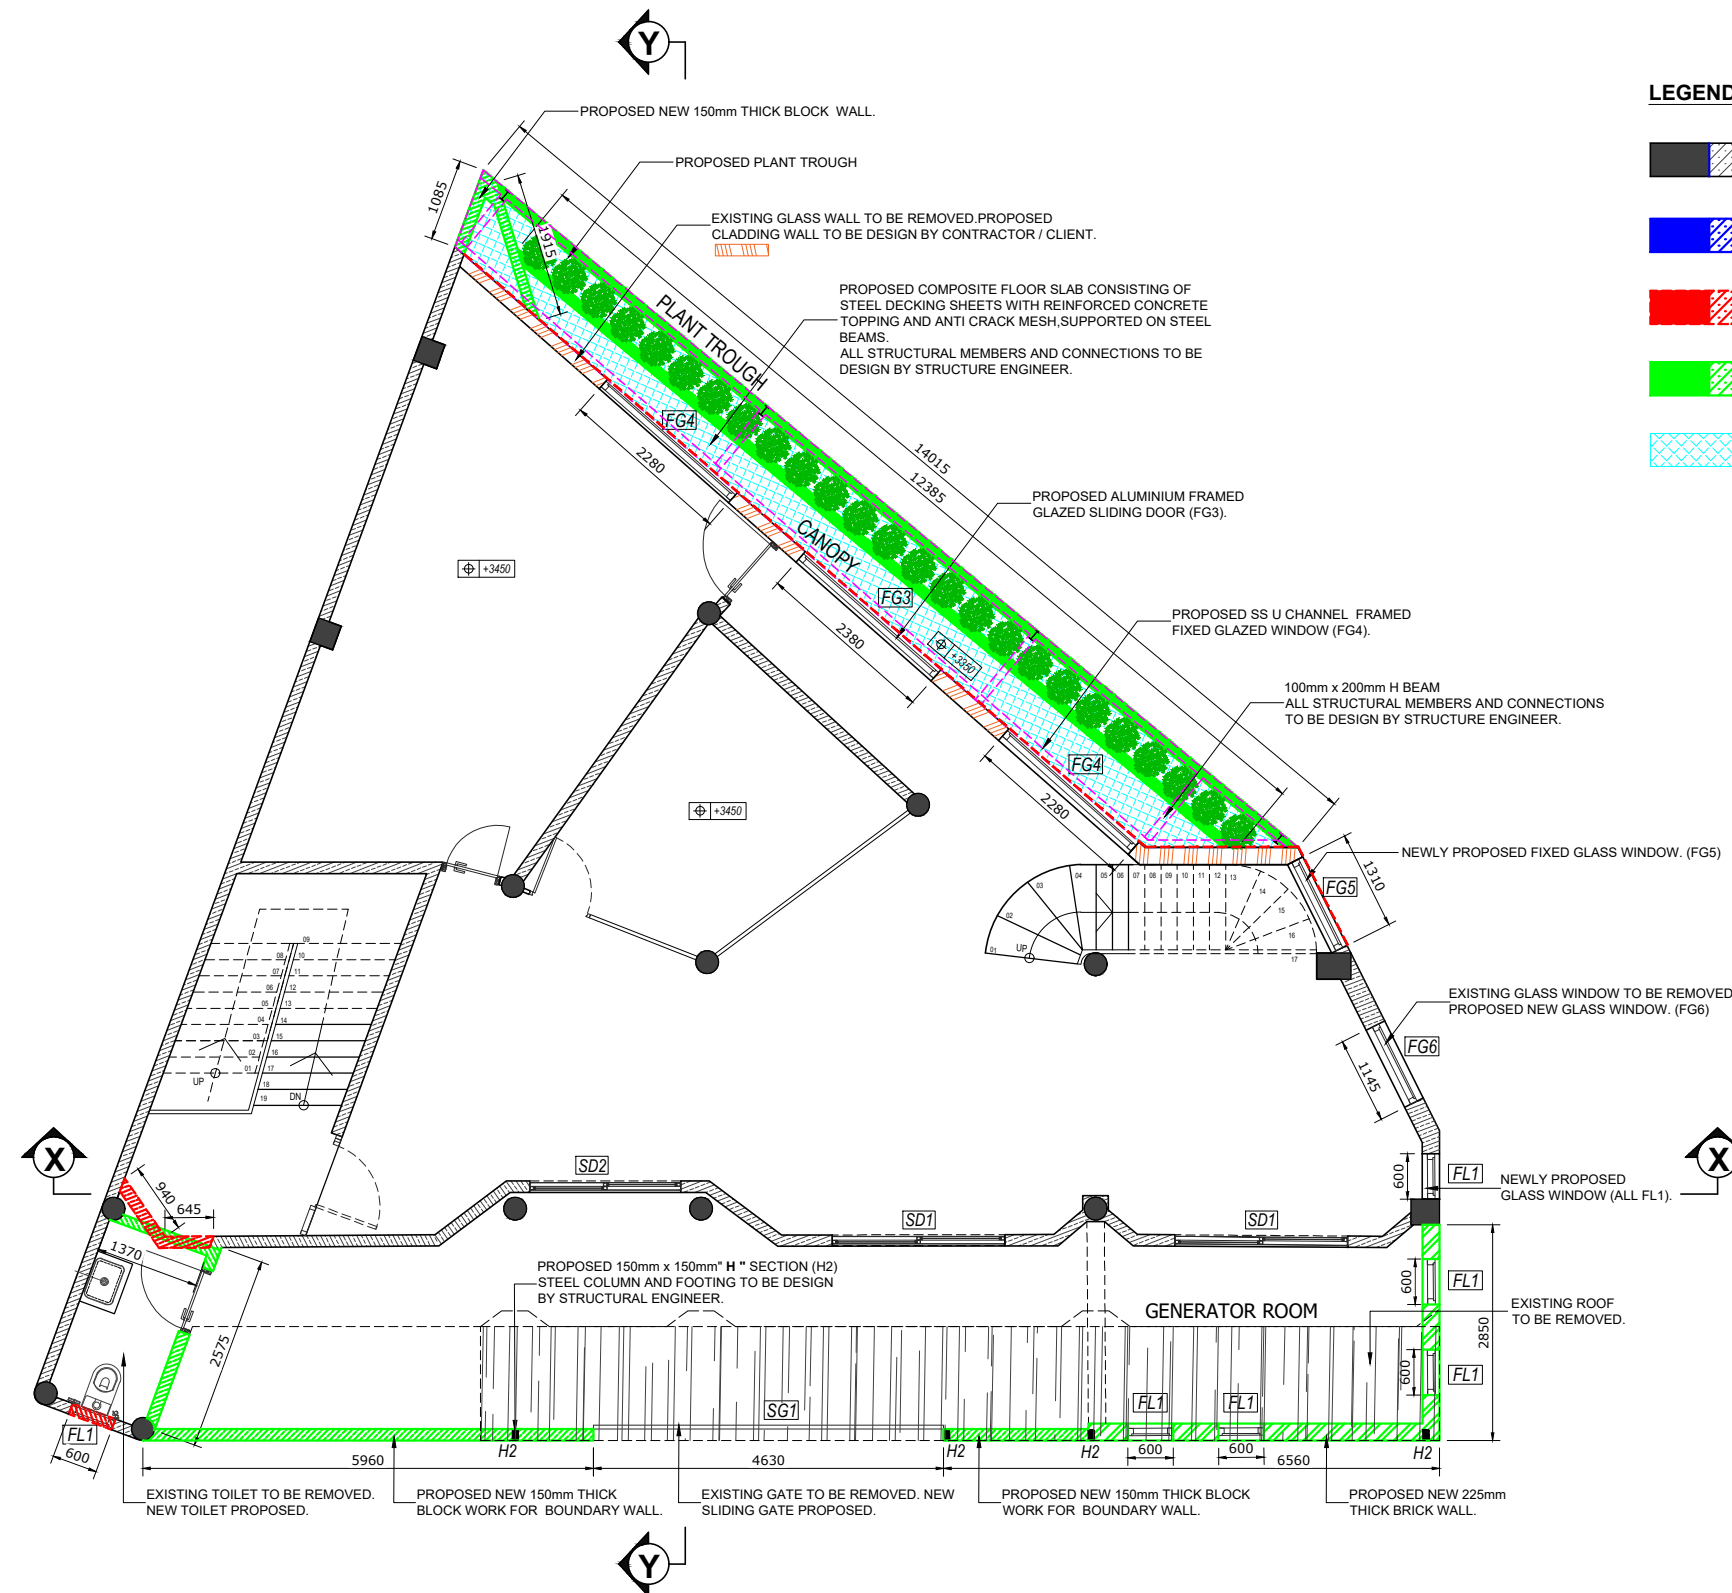

PROPOSED GROUND FLOOR LAYOUT


SCALE - 1 : 100

AREA 146.90m²

LEGEND

- ALREADY CONSTRUCTED COLUMNS & WALLS NOT REQUIRED TO DEMOLISH
- ALREADY CONSTRUCTED COLUMNS & WALLS REQUIRED TO DEMOLISH & RECONSTRUCTION
- EXISTING COLUMNS & WALLS TO BE DEMOLISHED
- COLUMNS & WALLS TO BE NEWLY BUILD-UP
- SLAB TO BE NEWLY BUILD-UP

KEY PLAN:

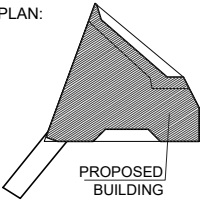

GENERAL NOTES :

ALL DIMENSIONS ARE IN MILLIMETERS UNLESS OTHERWISE MENTIONED.

NO DIMENSIONS TO BE SCALED OFF FROM DRAWINGS ONLY WRITTEN DIMENSIONS TO BE FOLLOWED.

IN THE EVENT OF ANY DISCREPANCIES OR DIFFERENCE BETWEEN ANY ARCHITECTURAL DRAWINGS AND STRUCTURAL DRAWINGS OR OTHER ENGINEERING DRAWINGS OR SITE CONDITIONS OR OTHERWISE IMMEDIATE REFERENCE IS TO BE MADE TO THE ARCHITECT FOR CLARIFICATION PRIOR TO EXECUTION OF WORK AT SITE.

PROJECT TITLE :

PROPOSED
REFURBISHMENT
BUILDING

CLIENT :



PEOPLE'S & FINANCE PLC

No.35/2D,
WELIMADA ROAD,
BANDARAWELA.

PROJECT DESIGN :



PREMIER ENTRANCE
TECHNOLOGIES (PVT) LTD,

No. 159/7/A,
KOSGAHAHENA JUNCTION,
PANNIPITIYA.

Tel : +94 112 851 729

Mobile : +94 713 270 996 /

+94 778 144 551

Web : www.premierentrance.com

Email : info@premierentrance.com

- ☐ A-APPROVED
- ☐ B-APPROVED AS COMMENTED
- ☐ C-REVISE & RESUBMIT
- ☐ D-FOR INFORMATION

AUTHORIZED SIGNATURE

DATE :

REV. NO.	BRIEF DESCRIPTION	DATE


DRAWING TITLE:

PROPOSED LAYOUT
GROUND FLOOR

SHOP DRAWINGS

Scale: AS SHOWN A3 Drawn by: SANDUN Checked by: PET Approved by: CLIENT

DATE: 13-06-2026 DRAWING NO.: PET-AR-SPD-2026-08-02 REV. 0

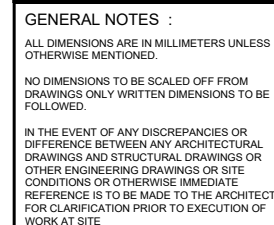

PROPOSED
REFURBISHMENT
BUILDING



**PREMIER ENTRANCE
TECHNOLOGIES (PVT)LTD,**
No. 159/7/A,
KOSGAHAHENA JUNCTION,
PANNIPITIYA.
Tel : +94 112 851 729
Mobile : +94 713 270 996 /
+94 778 144 551
Web : www.premierentrance.com
Email : info@premierentrance.com

- ☐ A-APPROVED
☐ B-APPROVED AS COMMENTED
☐ C-REVISE & RESUBMIT
☐ D-FOR INFORMATION

AUTHORIZED SIGNATURE

DATE : _____


△		
△		
REV. NO.	BRIEF DESCRIPTION	D


REV. NO.	BRIEF DESCRIPTION
	REFERENCE DRAWINGS

PROPOSED LAYOUT
FIRST FLOOR

Scale: AS SHOWN A3	Drawn by: SANDUN	Checked by: PET	Approved by: CLIENT
-----------------------	---------------------	--------------------	------------------------

DATE :	DRAWING NO.:	REV
13-06-2026	PET-AR-SPD-2026-08-03	0

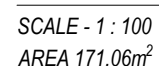

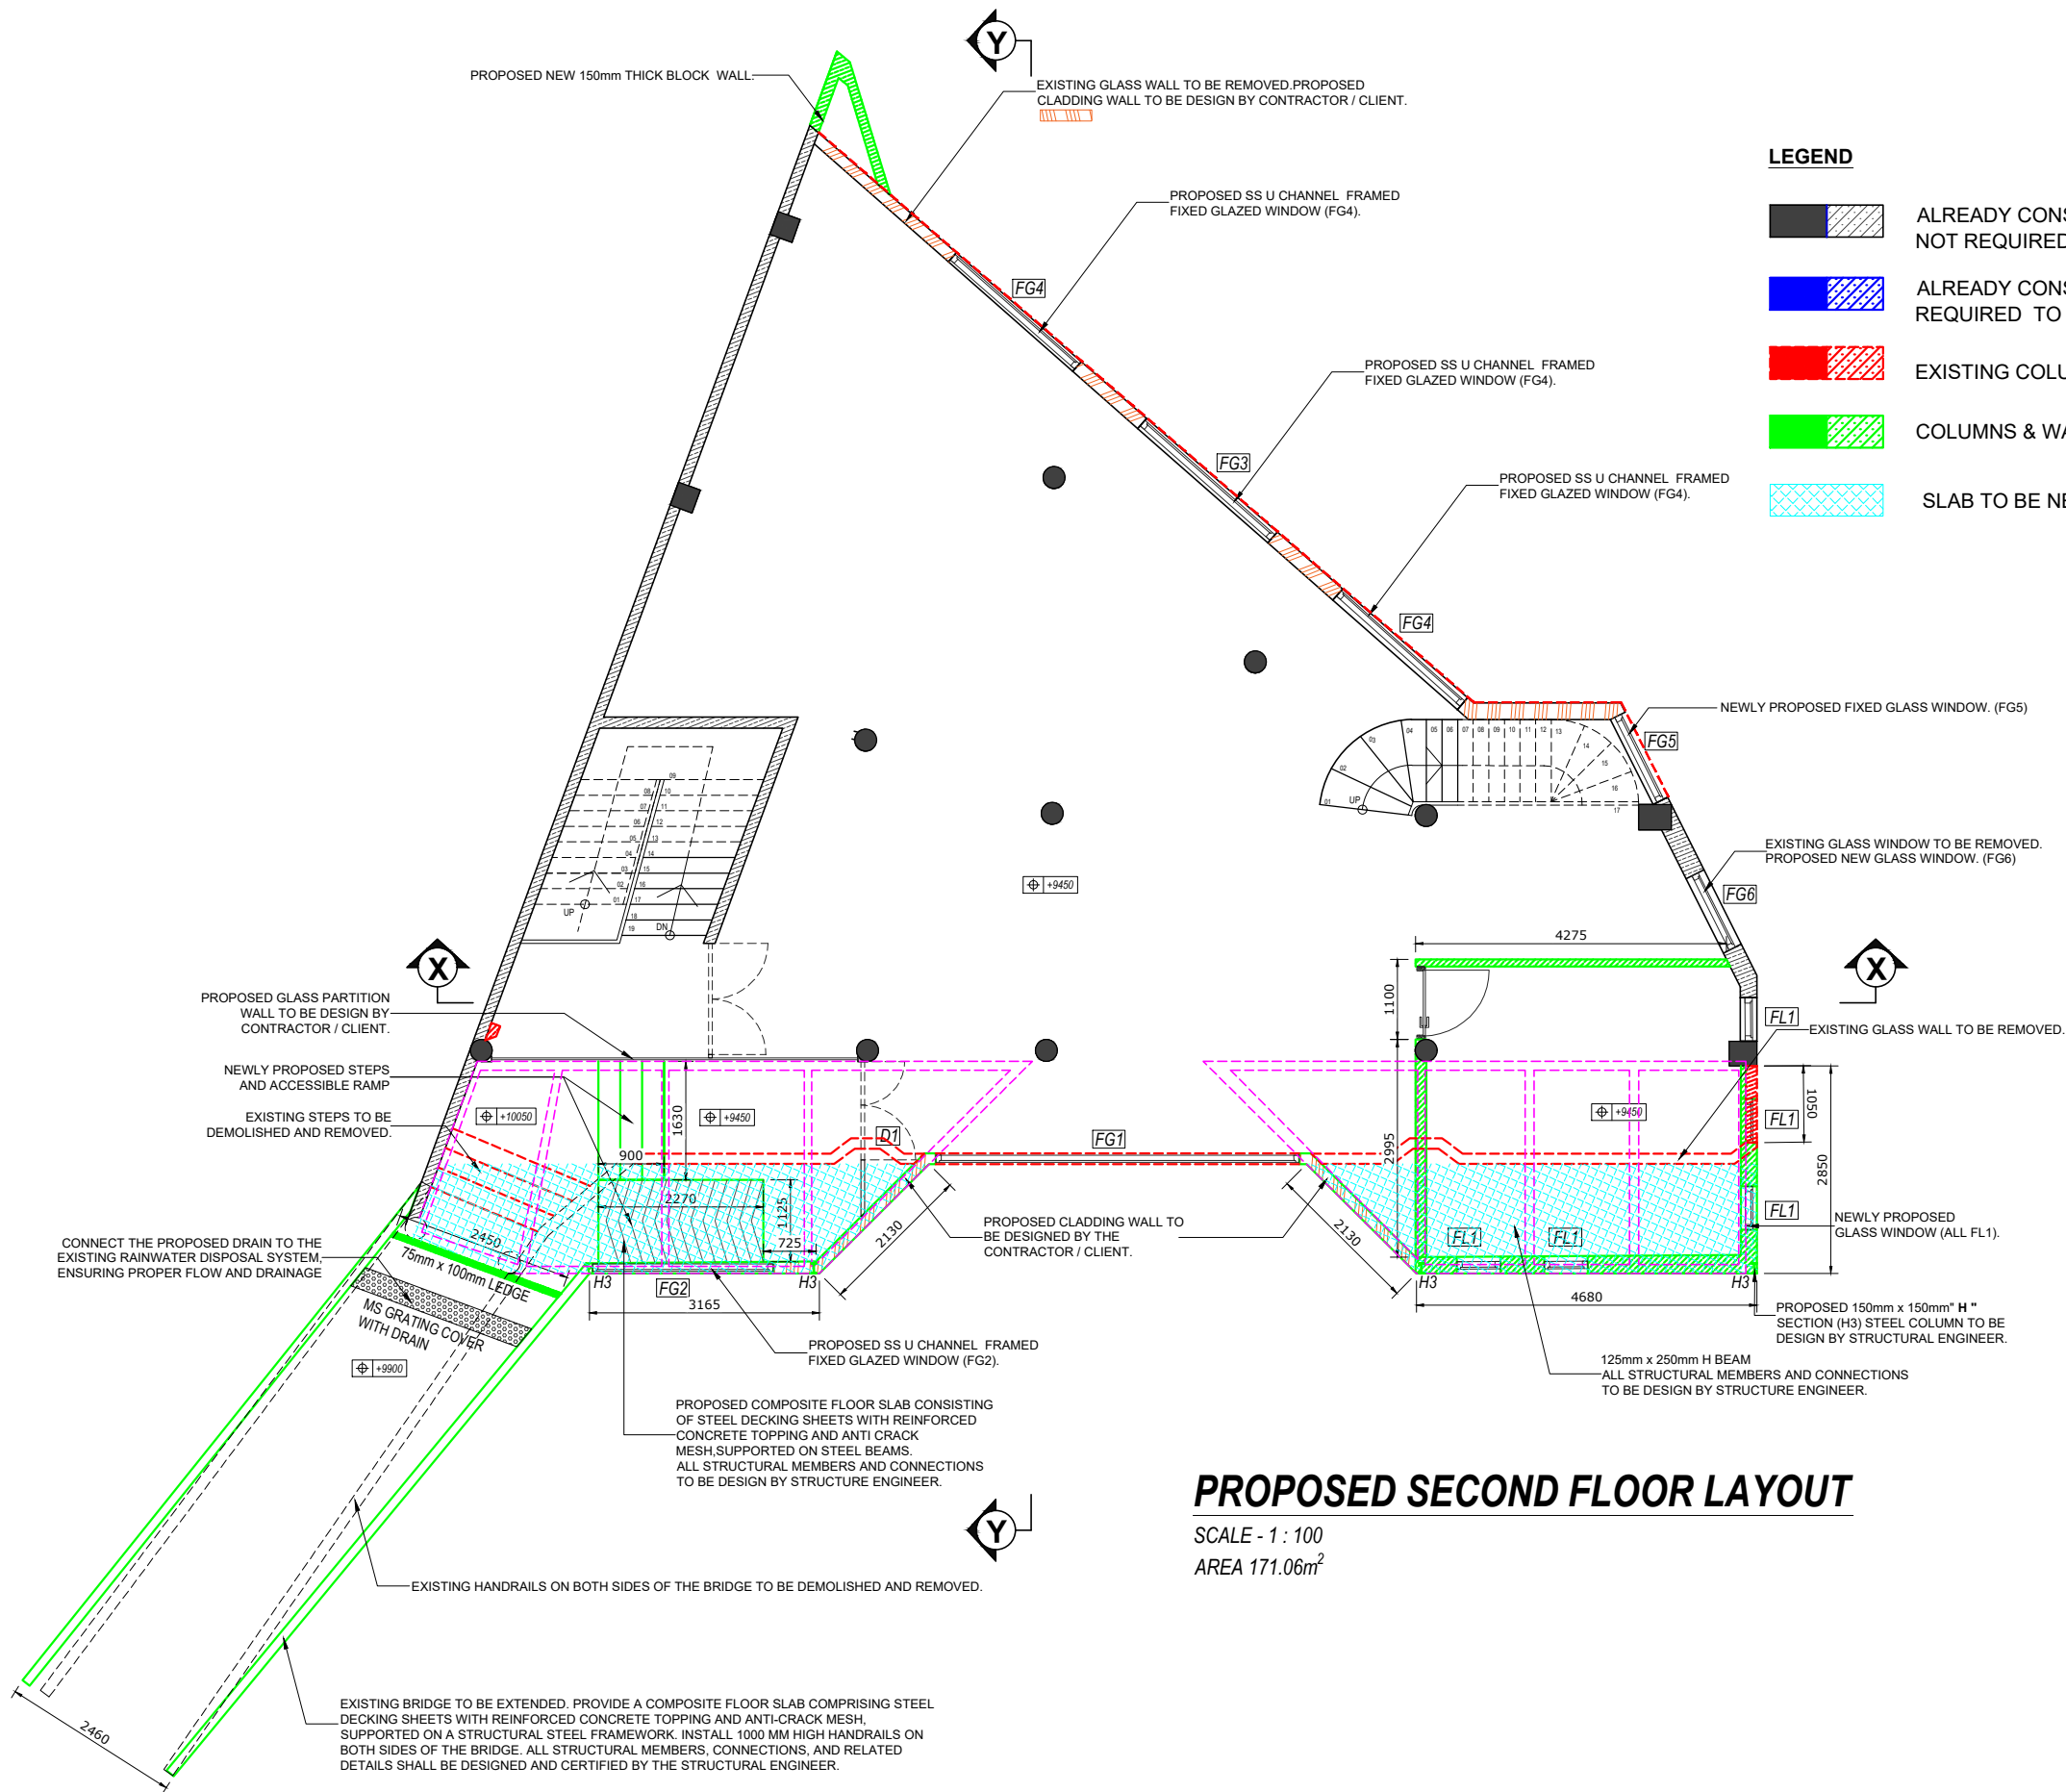

PROPOSED SECOND FLOOR LAYOUT


SCALE - 1 : 100

AREA 171.06m²

LEGEND

- ALREADY CONSTRUCTED COLUMNS & WALLS NOT REQUIRED TO DEMOLISH
- ALREADY CONSTRUCTED COLUMNS & WALLS REQUIRED TO DEMOLISH & RECONSTRUCTION
- EXISTING COLUMNS & WALLS TO BE DEMOLISHED
- COLUMNS & WALLS TO BE NEWLY BUILD-UP
- SLAB TO BE NEWLY BUILD-UP

KEY PLAN:

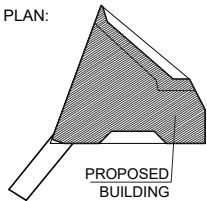

GENERAL NOTES :

ALL DIMENSIONS ARE IN MILLIMETERS UNLESS OTHERWISE MENTIONED.

NO DIMENSIONS TO BE SCALED OFF FROM DRAWINGS ONLY WRITTEN DIMENSIONS TO BE FOLLOWED.

IN THE EVENT OF ANY DISCREPANCIES OR DIFFERENCE BETWEEN ANY ARCHITECTURAL DRAWINGS AND STRUCTURAL DRAWINGS OR OTHER ENGINEERING DRAWINGS OR SITE CONDITIONS OR OTHERWISE IMMEDIATE REFERENCE IS TO BE MADE TO THE ARCHITECT FOR CLARIFICATION PRIOR TO EXECUTION OF WORK AT SITE.

PROJECT TITLE :

PROPOSED
REFURBISHMENT
BUILDING

CLIENT :



PEOPLE'S & FINANCE PLC

No.35/2D,
WELIMADA ROAD,
BANDARAWELA.

PROJECT DESIGN :



PREMIER ENTRANCE
TECHNOLOGIES (PVT) LTD,
No. 159/77A,
KOSGAHAHENA JUNCTION,
PANNIPITIYA.

Tel : +94 112 851 729

Mobile : +94 713 270 996 /

+94 778 144 551

Web : www.premierentrance.com

Email : info@premierentrance.com

- ☐ A-APPROVED
- ☐ B-APPROVED AS COMMENTED
- ☐ C-REVISE & RESUBMIT
- ☐ D-FOR INFORMATION

AUTHORIZED SIGNATURE

DATE :

REV. NO.	BRIEF DESCRIPTION	DATE
1		
2		
3		
4		
5		
6		
7		
8		
9		
10		

REFERENCE DRAWINGS


DRAWING TITLE:

PROPOSED LAYOUT
SECOND FLOOR

SHOP DRAWINGS

Scale: AS SHOWN A3 Drawn by: SANDUN Checked by: PET Approved by: CLIENT


DATE: 13-06-2026 DRAWING NO.: PET-AR-SPD-2026-08-04 REV. 0

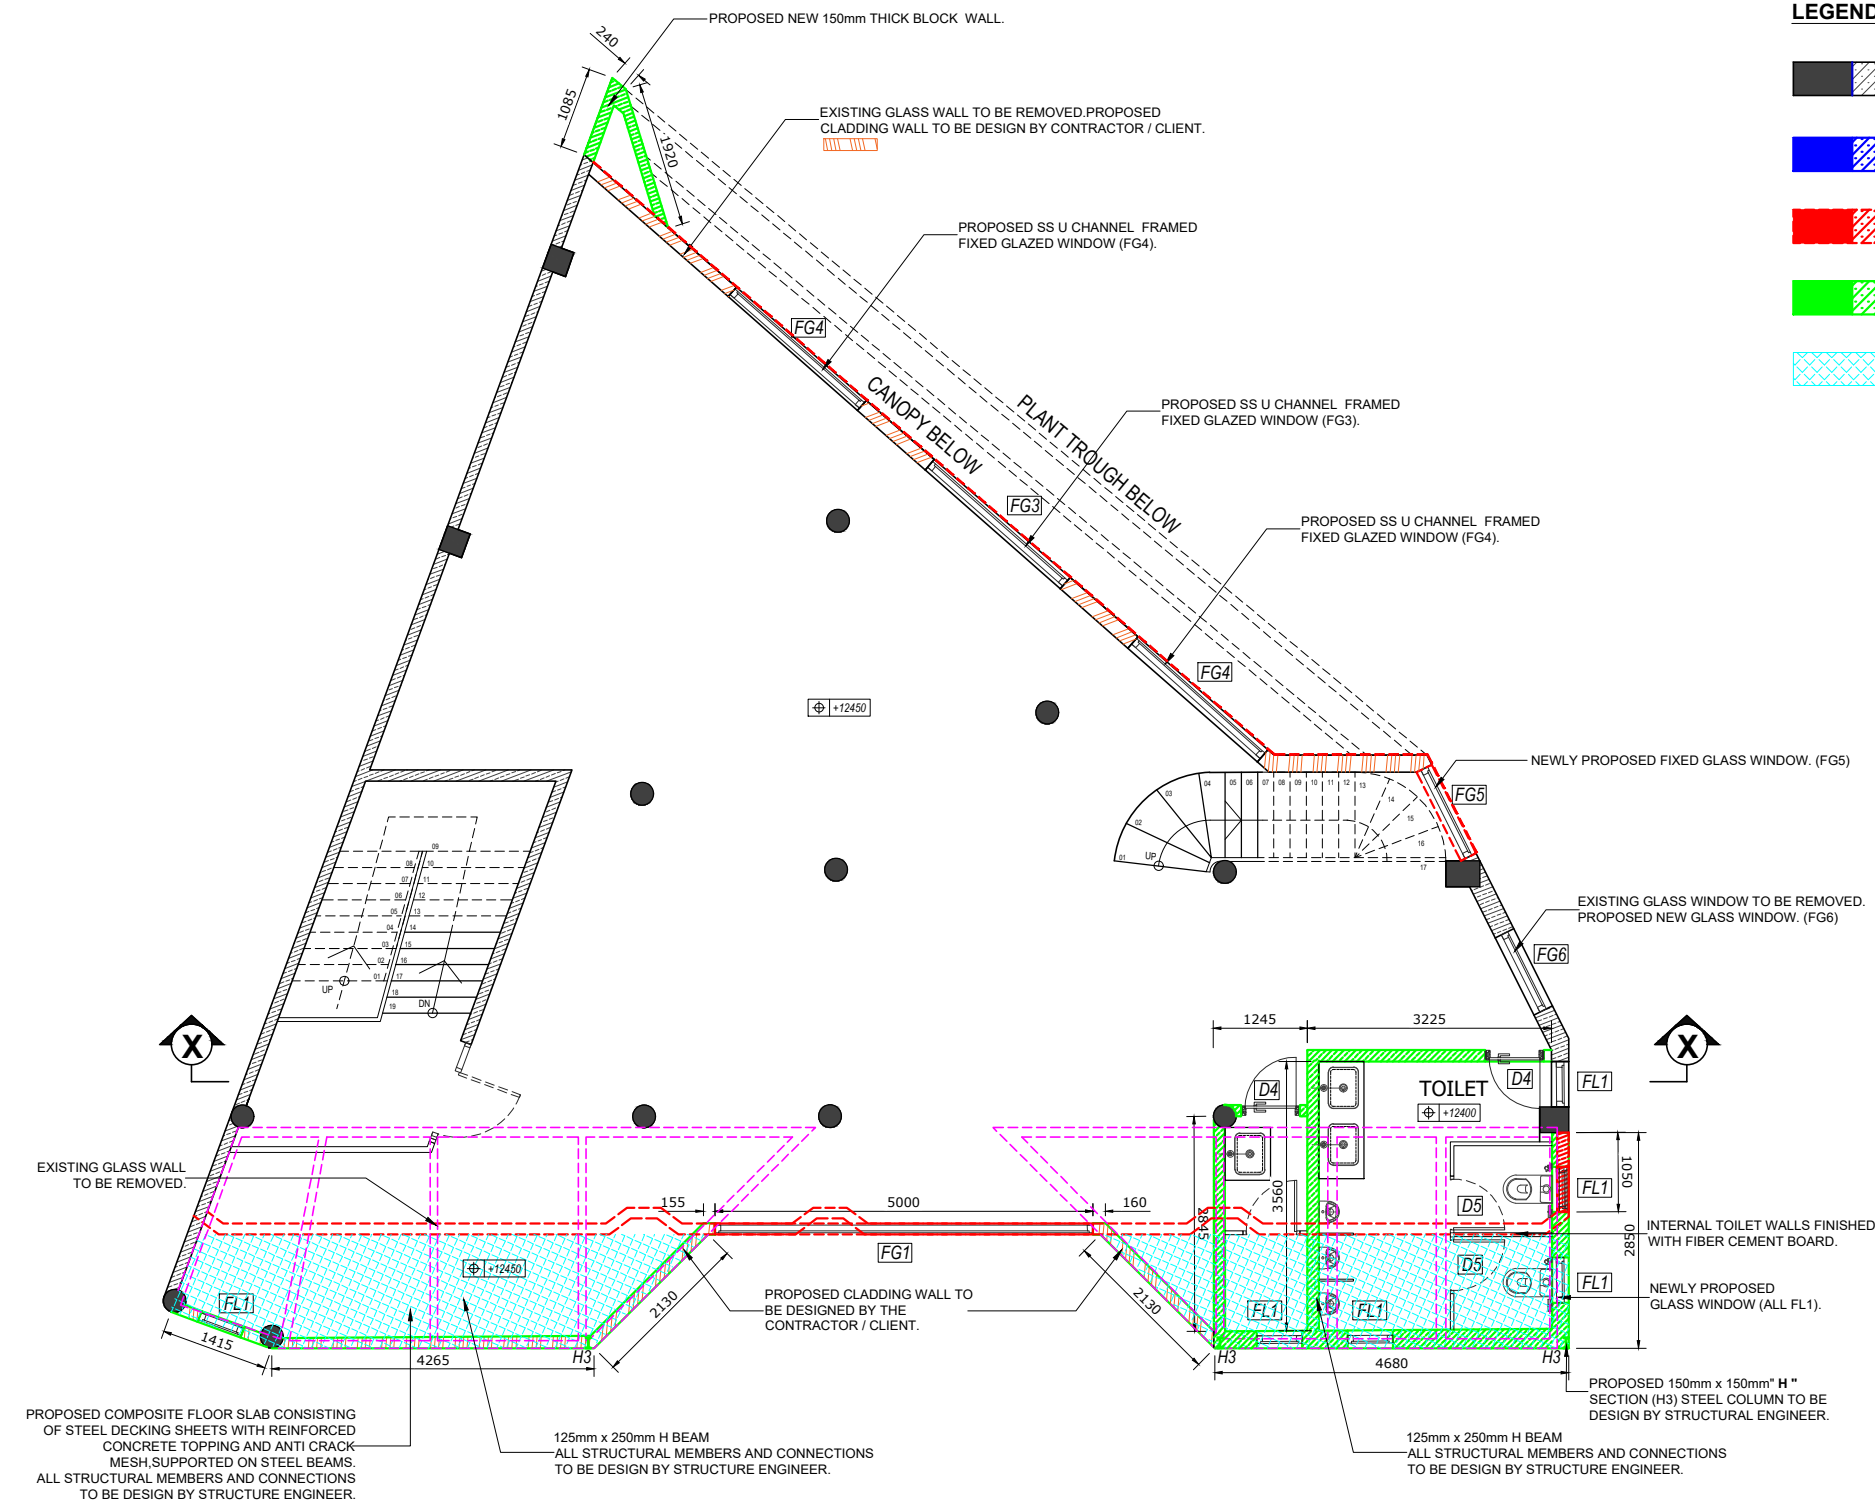

LEGEND

- ALREADY CONSTRUCTED COLUMNS & WALLS NOT REQUIRED TO DEMOLISH
- ALREADY CONSTRUCTED COLUMNS & WALLS REQUIRED TO DEMOLISH & RECONSTRUCTION
- EXISTING COLUMNS & WALLS TO BE DEMOLISHED
- COLUMNS & WALLS TO BE NEWLY BUILD-UP
- SLAB TO BE NEWLY BUILD-UP

PROPOSED THIRD FLOOR LAYOUT

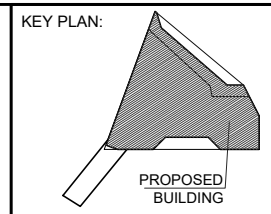

GENERAL NOTES :

ALL DIMENSIONS ARE IN MILLIMETERS UNLESS OTHERWISE MENTIONED.

NO DIMENSIONS TO BE SCALED OFF FROM DRAWINGS ONLY WRITTEN DIMENSIONS TO BE FOLLOWED.

IN THE EVENT OF ANY DISCREPANCIES OR DIFFERENCE BETWEEN ANY ARCHITECTURAL DRAWINGS AND STRUCTURAL DRAWINGS OR OTHER ENGINEERING DRAWINGS OR SITE CONDITIONS OR OTHERWISE IMMEDIATE REFERENCE IS TO BE MADE TO THE ARCHITECT FOR CLARIFICATION PRIOR TO EXECUTION OF WORK AT SITE.

PROJECT TITLE :

PROPOSED REFURBISHMENT BUILDING

CLIENT :



PEOPLE'S & FINANCE PLC
No.35/2D,
WELIMADA ROAD,
BANDARAWELA.

PROJECT DESIGN :



PREMIER ENTRANCE TECHNOLOGIES (PVT) LTD,
No. 159/7/A,
KOSGAHAHENA JUNCTION,
PANNIPITIYA.
Tel : +94 112 851 729
Mobile : +94 713 270 996 /
+94 778 144 551
Web : www.premierentrance.com
Email : info@premierentrance.com

- ☐ A-APPROVED
- ☐ B-APPROVED AS COMMENTED
- ☐ C-REVISE & RESUBMIT
- ☐ D-FOR INFORMATION

AUTHORIZED SIGNATURE

DATE :


REV. NO.	BRIEF DESCRIPTION	DATE

DRAWING TITLE:

PROPOSED LAYOUT THIRD FLOOR FLOOR


SHOP DRAWINGS

Scale:	Drawn by:	Checked by:	Approved by:
AS SHOWN A3	SANDUN	PET	CLIENT
DATE:	DRAWING NO.:	REV.:	
13-06-2026	PET-AR-SPD-2026-08-05	0	

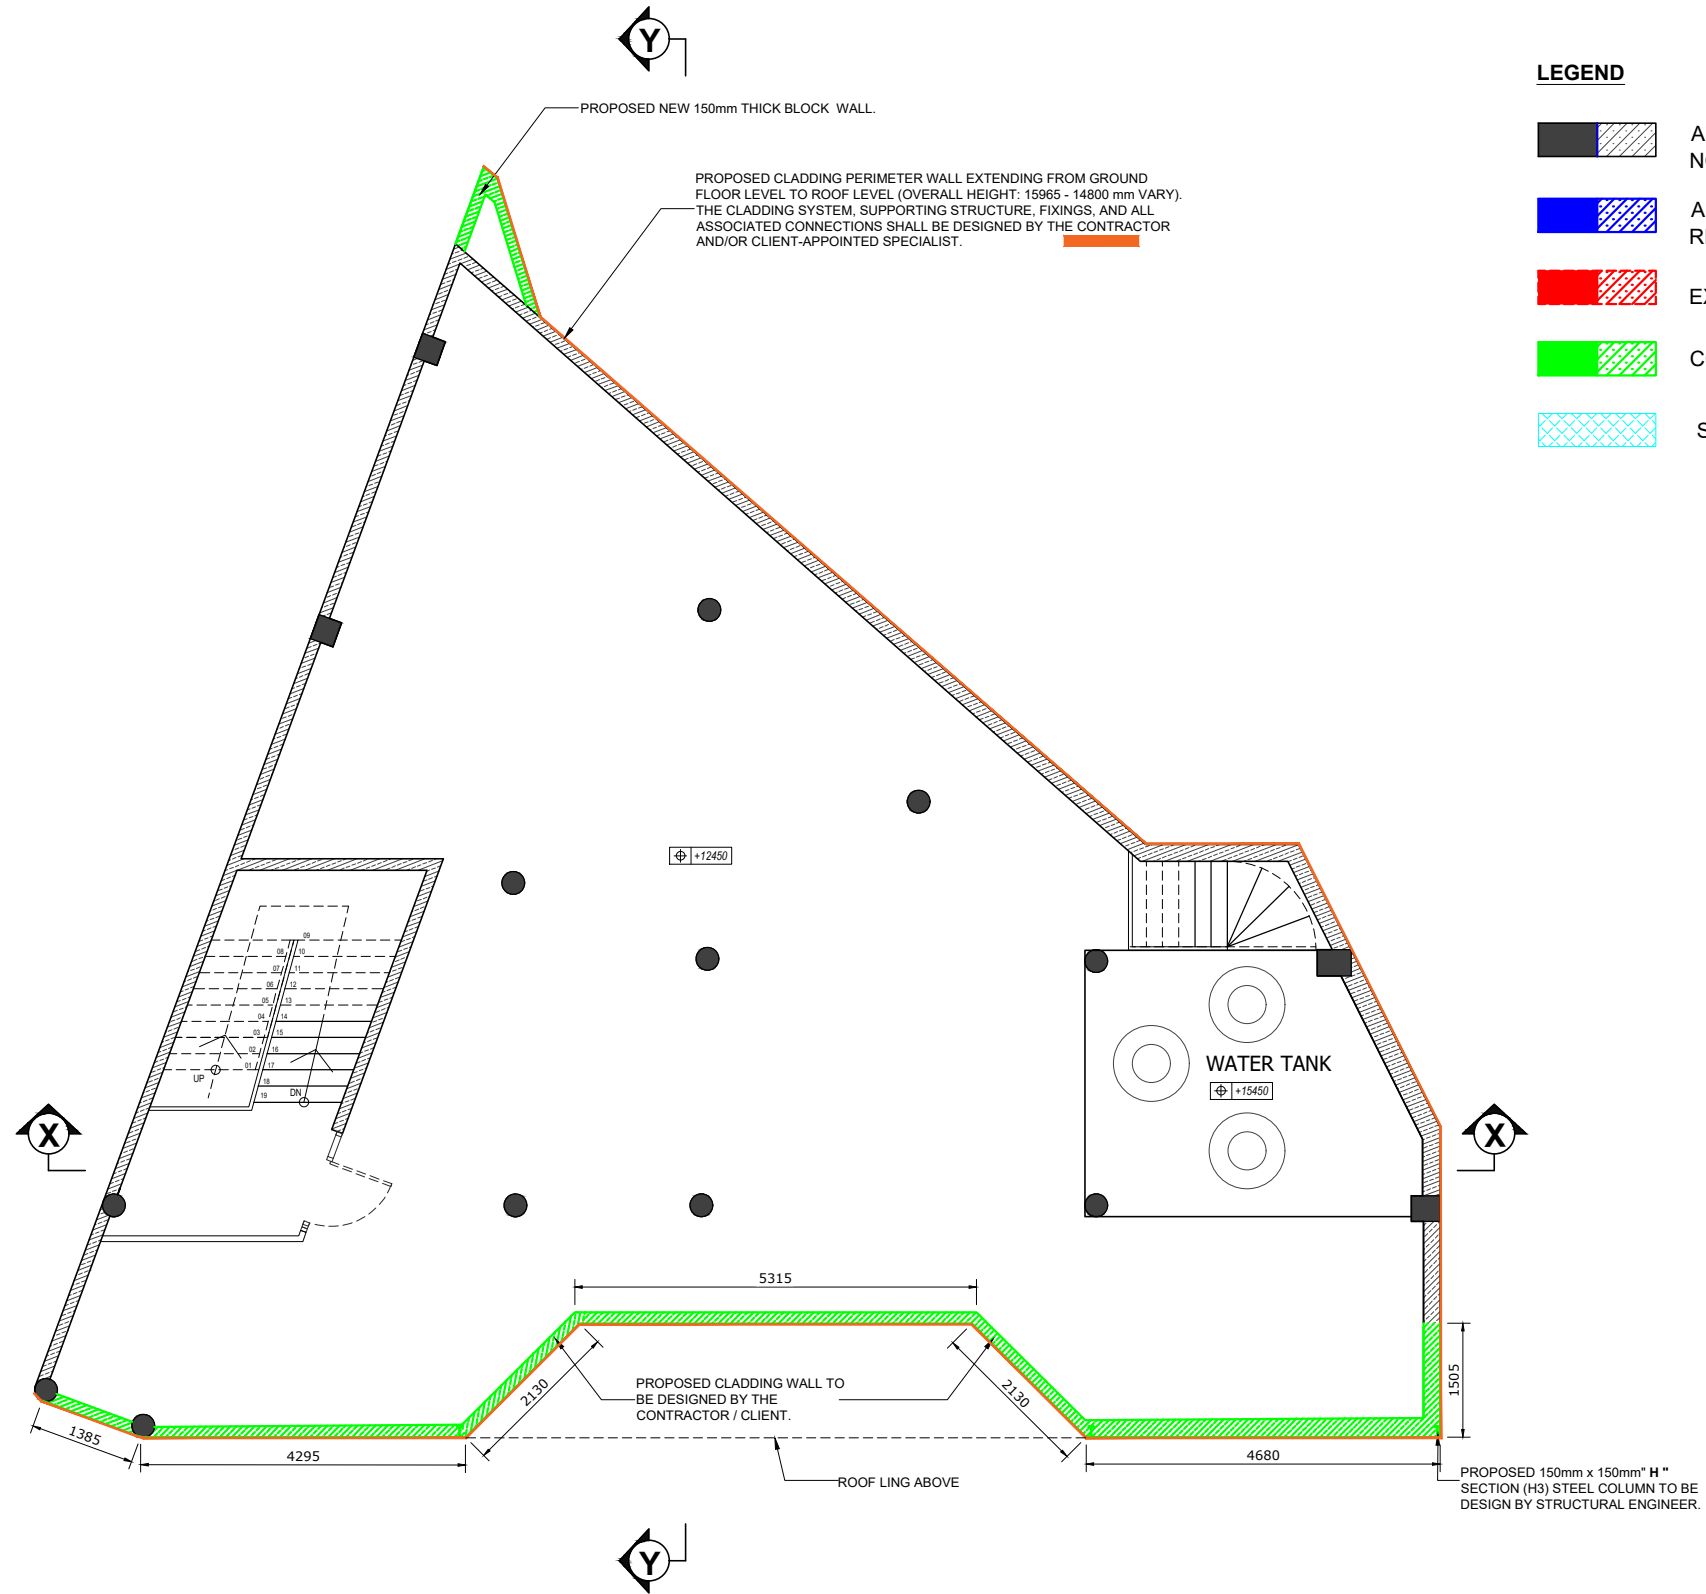

PROPOSED WATER TANK FLOOR LAYOUT
SCALE - 1 : 100
AREA 25.98m²

- LEGEND**
- ALREADY CONSTRUCTED COLUMNS & WALLS NOT REQUIRED TO DEMOLISH
 - ALREADY CONSTRUCTED COLUMNS & WALLS REQUIRED TO DEMOLISH & RECONSTRUCTION
 - EXISTING COLUMNS & WALLS TO BE DEMOLISHED
 - COLUMNS & WALLS TO BE NEWLY BUILD-UP
 - SLAB TO BE NEWLY BUILD-UP

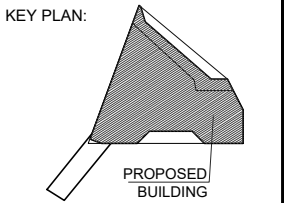

GENERAL NOTES :
ALL DIMENSIONS ARE IN MILLIMETERS UNLESS OTHERWISE MENTIONED.
NO DIMENSIONS TO BE SCALED OFF FROM DRAWINGS ONLY WRITTEN DIMENSIONS TO BE FOLLOWED.
IN THE EVENT OF ANY DISCREPANCIES OR DIFFERENCE BETWEEN ANY ARCHITECTURAL DRAWINGS AND STRUCTURAL DRAWINGS OR OTHER ENGINEERING DRAWINGS OR SITE CONDITIONS OR OTHERWISE IMMEDIATE REFERENCE IS TO BE MADE TO THE ARCHITECT FOR CLARIFICATION PRIOR TO EXECUTION OF WORK AT SITE.

PROJECT TITLE :
PROPOSED REFURBISHMENT BUILDING

CLIENT :

PEOPLE'S & FINANCE PLC
No.35/2D,
WELIMADA ROAD,
BANDARAWELA.

PROJECT DESIGN :

PREMIER ENTRANCE TECHNOLOGIES (PVT)LTD,
No. 159/7/A,
KOSGAHAHENA JUNCTION,
PANNIPITIYA.
Tel : +94 112 851 729
Mobile : +94 713 270 996 /
+94 778 144 551
Web : www.premierentrance.com
Email : info@premierentrance.com

- ☐ A-APPROVED
- ☐ B-APPROVED AS COMMENTED
- ☐ C-REVISE & RESUBMIT
- ☐ D-FOR INFORMATION

AUTHORIZED SIGNATURE

DATE :


REV.NO	BRIEF DESCRIPTION	DATE

REFERENCE DRAWINGS


DRAWING TITLE:
PROPOSED LAYOUT WATER TANK LEVEL

SHOP DRAWINGS

Scale: AS SHOWN A3	Drawn by: SANDUN	Checked by: PET	Approved by: CLIENT
DATE: 13-06-2026	DRAWING NO.: PET-AR-SPD-2026-08-06	REV. 0	

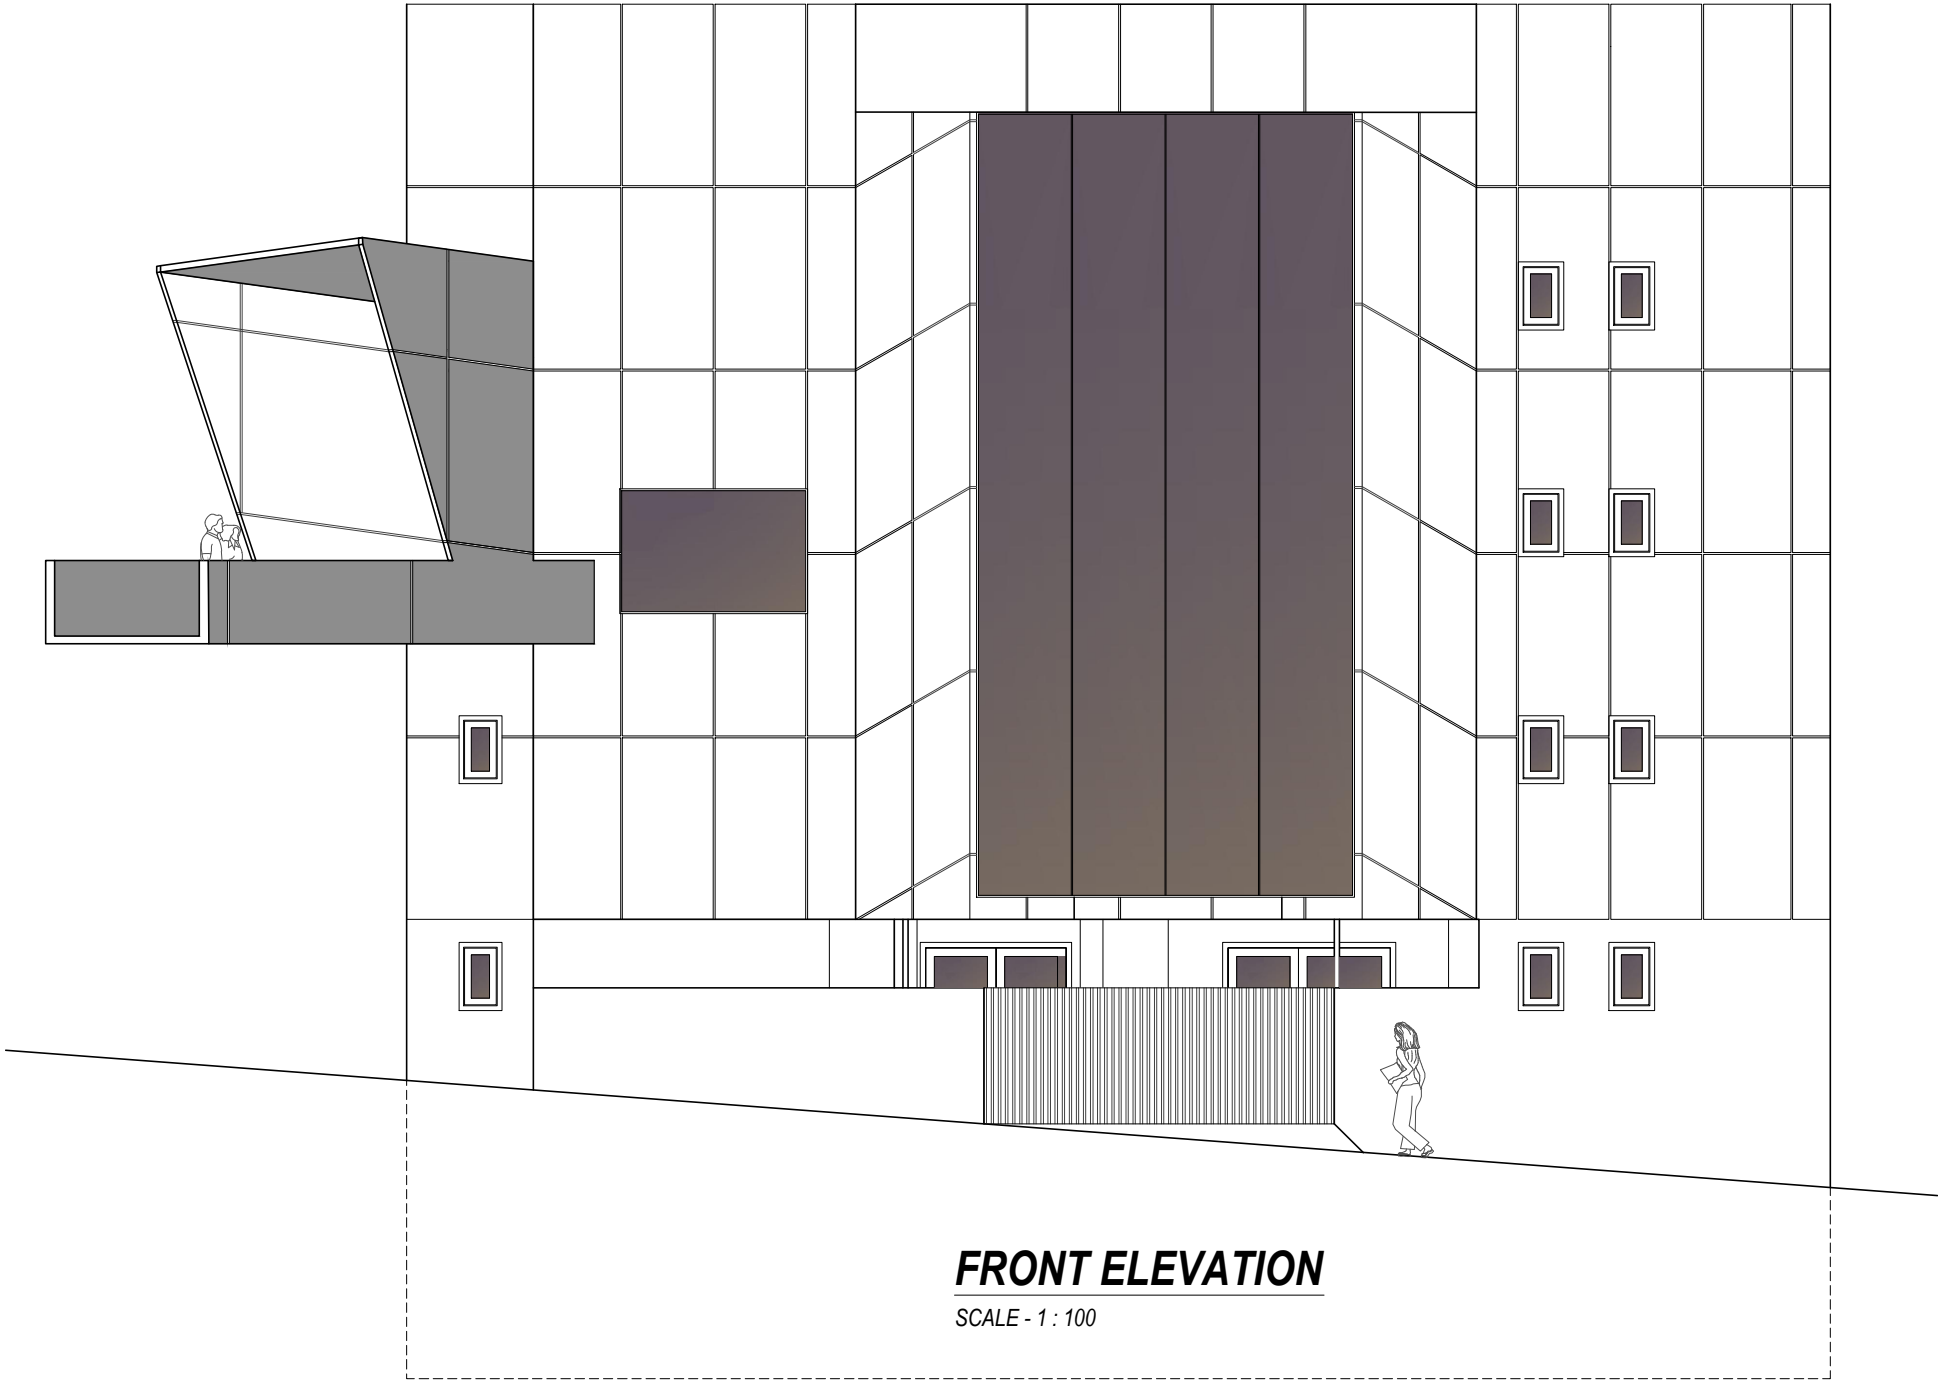

FRONT ELEVATION
SCALE - 1 : 100

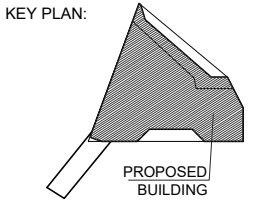

GENERAL NOTES :

ALL DIMENSIONS ARE IN MILLIMETERS UNLESS OTHERWISE MENTIONED.

NO DIMENSIONS TO BE SCALED OFF FROM DRAWINGS ONLY WRITTEN DIMENSIONS TO BE FOLLOWED.

IN THE EVENT OF ANY DISCREPANCIES OR DIFFERENCE BETWEEN ANY ARCHITECTURAL DRAWINGS AND STRUCTURAL DRAWINGS OR OTHER ENGINEERING DRAWINGS OR SITE CONDITIONS OR OTHERWISE IMMEDIATE REFERENCE IS TO BE MADE TO THE ARCHITECT FOR CLARIFICATION PRIOR TO EXECUTION OF WORK AT SITE.

PROJECT TITLE :

**PROPOSED
REFURBISHMENT
BUILDING**

CLIENT :



PEOPLE'S & FINANCE PLC
No.35/2D,
WELIMADA ROAD,
BANDARAWELA.

PROJECT DESIGN :



**PREMIER ENTRANCE
TECHNOLOGIES (PVT)LTD,**
No. 159/7/A,
KOSGAHAHENA JUNCTION,
PANNIPITIYA.
Tel : +94 112 851 729
Mobile : +94 713 270 996 /
+94 778 144 551
Web : www.premierentrance.com
Email : info@premierentrance.com

☐ A-APPROVED
☐ B-APPROVED AS COMMENTED
☐ C-REVISE & RESUBMIT
☐ D-FOR INFORMATION

AUTHORIZED SIGNATURE

DATE :

△		
△		
REV.NO	BRIEF DESCRIPTION	DATE

REFERENCE DRAWINGS		

DRAWING TITLE:


FRONT ELEVATION

SHOP DRAWINGS			
Scale: AS SHOWN A3	Drawn by: SANDUN	Checked by: PET	Approved by: CLIENT
DATE : 13-06-2026	DRAWING NO.: PET-AR-SPD-2026-08-08	REV.: 0	

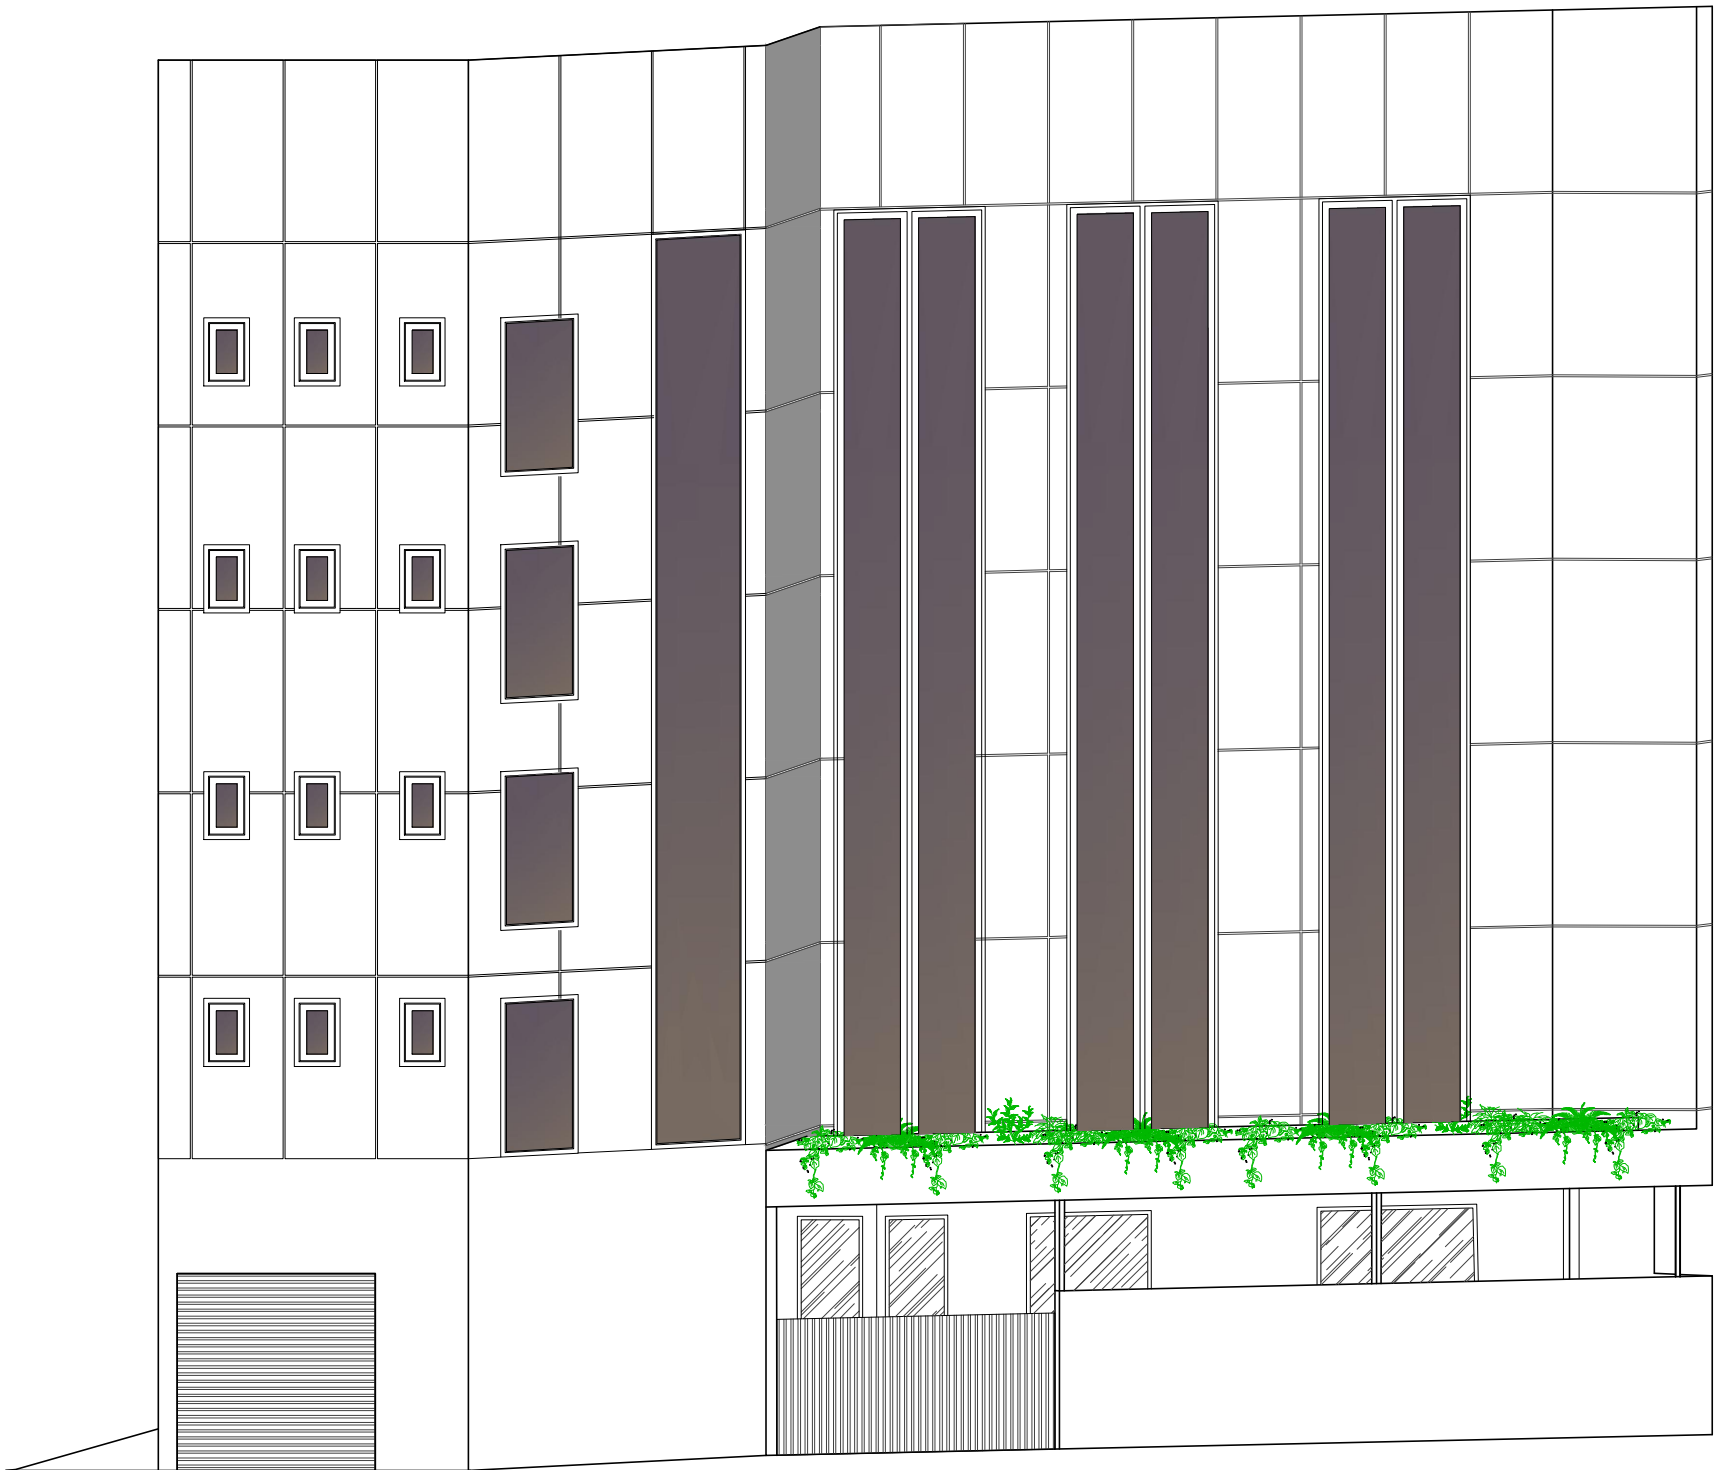

RIGHT SIDE ELEVATION

SCALE - 1 : 100

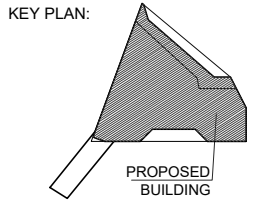

GENERAL NOTES :

ALL DIMENSIONS ARE IN MILLIMETERS UNLESS OTHERWISE MENTIONED.

NO DIMENSIONS TO BE SCALED OFF FROM DRAWINGS ONLY WRITTEN DIMENSIONS TO BE FOLLOWED.

IN THE EVENT OF ANY DISCREPANCIES OR DIFFERENCE BETWEEN ANY ARCHITECTURAL DRAWINGS AND STRUCTURAL DRAWINGS OR OTHER ENGINEERING DRAWINGS OR SITE CONDITIONS OR OTHERWISE IMMEDIATE REFERENCE IS TO BE MADE TO THE ARCHITECT FOR CLARIFICATION PRIOR TO EXECUTION OF WORK AT SITE.

PROJECT TITLE :

**PROPOSED
REFURBISHMENT
BUILDING**

CLIENT :



PEOPLE'S & FINANCE PLC
No.35/2D,
WELIMADA ROAD,
BANDARAWELA.

PROJECT DESIGN :



**PREMIER ENTRANCE
TECHNOLOGIES (PVT)LTD,**
No. 159/7/A,
KOSGAHAHENA JUNCTION,
PANNIPITIYA.
Tel : +94 112 851 729
Mobile : +94 713 270 996 /
+94 778 144 551
Web : www.premierentrance.com
Email : info@premierentrance.com

- ☐ A-APPROVED
☐ B-APPROVED AS COMMENTED
☐ C-REVISE & RESUBMIT
☐ D-FOR INFORMATION

AUTHORIZED SIGNATURE

DATE :

△		
△		
REV.NO	BRIEF DESCRIPTION	DATE

REFERENCE DRAWINGS	
1	
2	
3	
4	


DRAWING TITLE:

RIGHT SIDE ELEVATION

SHOP DRAWINGS

Scale: AS SHOWN A3 Drawn by: SANDUN Checked by: PET Approved by: CLIENT


DATE: 13-06-2026 DRAWING NO.: PET-AR-SPD-2026-08-09 REV. 0

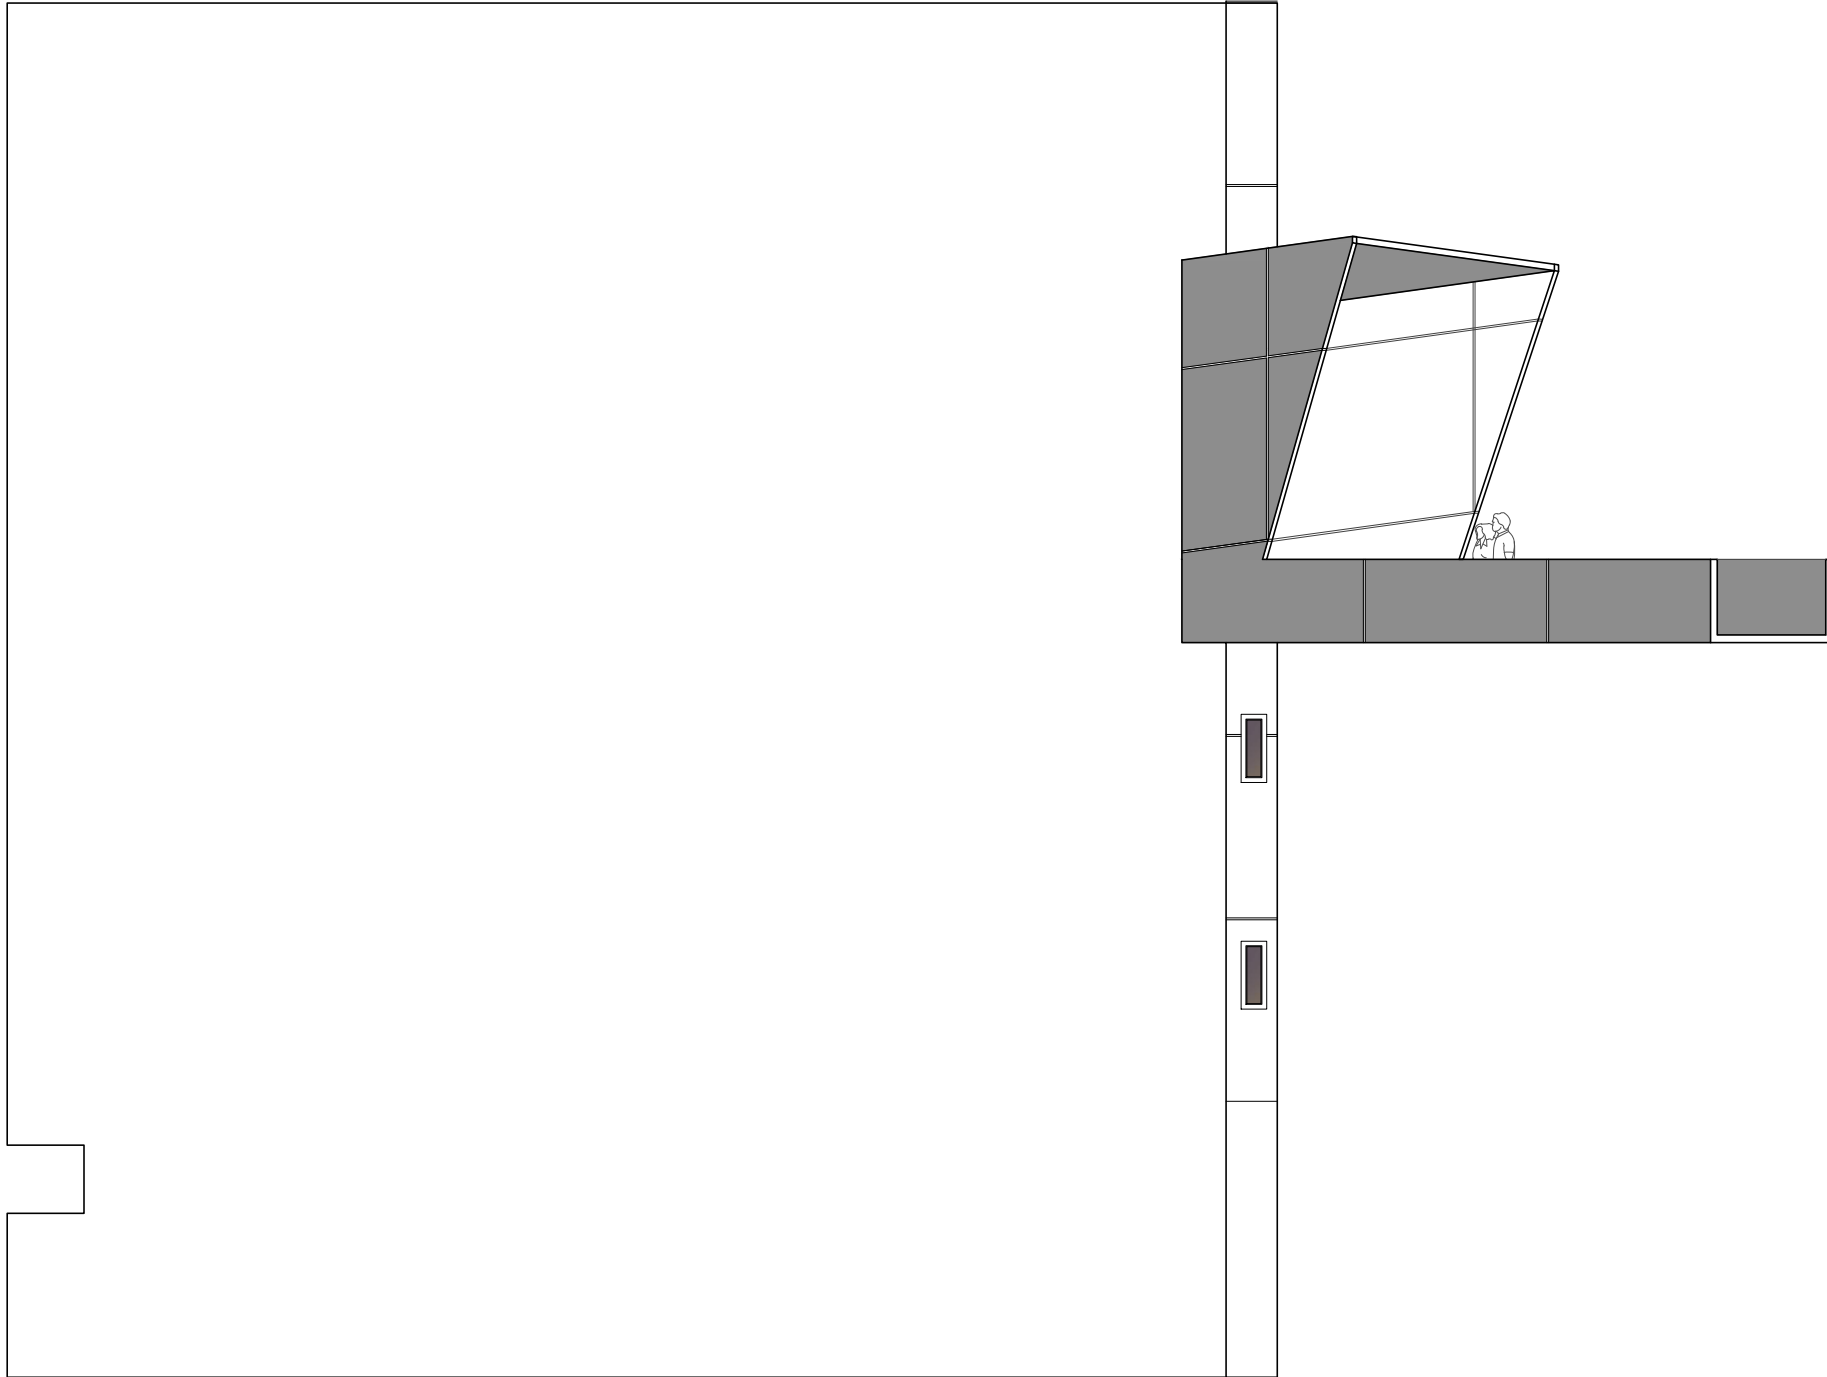

LEFT SIDE ELEVATION

SCALE - 1 : 100

KEY PLAN:

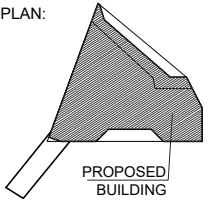

GENERAL NOTES :

ALL DIMENSIONS ARE IN MILLIMETERS UNLESS OTHERWISE MENTIONED.

NO DIMENSIONS TO BE SCALED OFF FROM DRAWINGS ONLY WRITTEN DIMENSIONS TO BE FOLLOWED.

IN THE EVENT OF ANY DISCREPANCIES OR DIFFERENCE BETWEEN ANY ARCHITECTURAL DRAWINGS AND STRUCTURAL DRAWINGS OR OTHER ENGINEERING DRAWINGS OR SITE CONDITIONS OR OTHERWISE IMMEDIATE REFERENCE IS TO BE MADE TO THE ARCHITECT FOR CLARIFICATION PRIOR TO EXECUTION OF WORK AT SITE.

PROJECT TITLE :

**PROPOSED
REFURBISHMENT
BUILDING**

CLIENT :



PEOPLE'S & FINANCE PLC

No.35/2D,
WELIMADA ROAD,
BANDARAWELA.

PROJECT DESIGN :



**PREMIER ENTRANCE
TECHNOLOGIES (PVT)LTD,**
No. 159/7/A,
KOSGAHAHENA JUNCTION,
PANNIPITIYA.

Tel : +94 112 851 729

Mobile : +94 713 270 996 /

+94 778 144 551

Web : www.premierentrance.com

Email : info@premierentrance.com

- ☐ A-APPROVED
- ☐ B-APPROVED AS COMMENTED
- ☐ C-REVISE & RESUBMIT
- ☐ D-FOR INFORMATION

AUTHORIZED SIGNATURE

DATE :

△		
△		
REV.NO	BRIEF DESCRIPTION	DATE
--------	-------------------	------

REFERENCE DRAWINGS		


DRAWING TITLE:

LEFT SIDE ELEVATION


SHOP DRAWINGS

Scale: AS SHOWN A3	Drawn by: SANDUN	Checked by: PET	Approved by: CLIENT
-----------------------	---------------------	--------------------	------------------------

DATE : 13-06-2026	DRAWING NO.: PET-AR-SPD-2026-08-10	REV. 0
----------------------	---------------------------------------	-----------

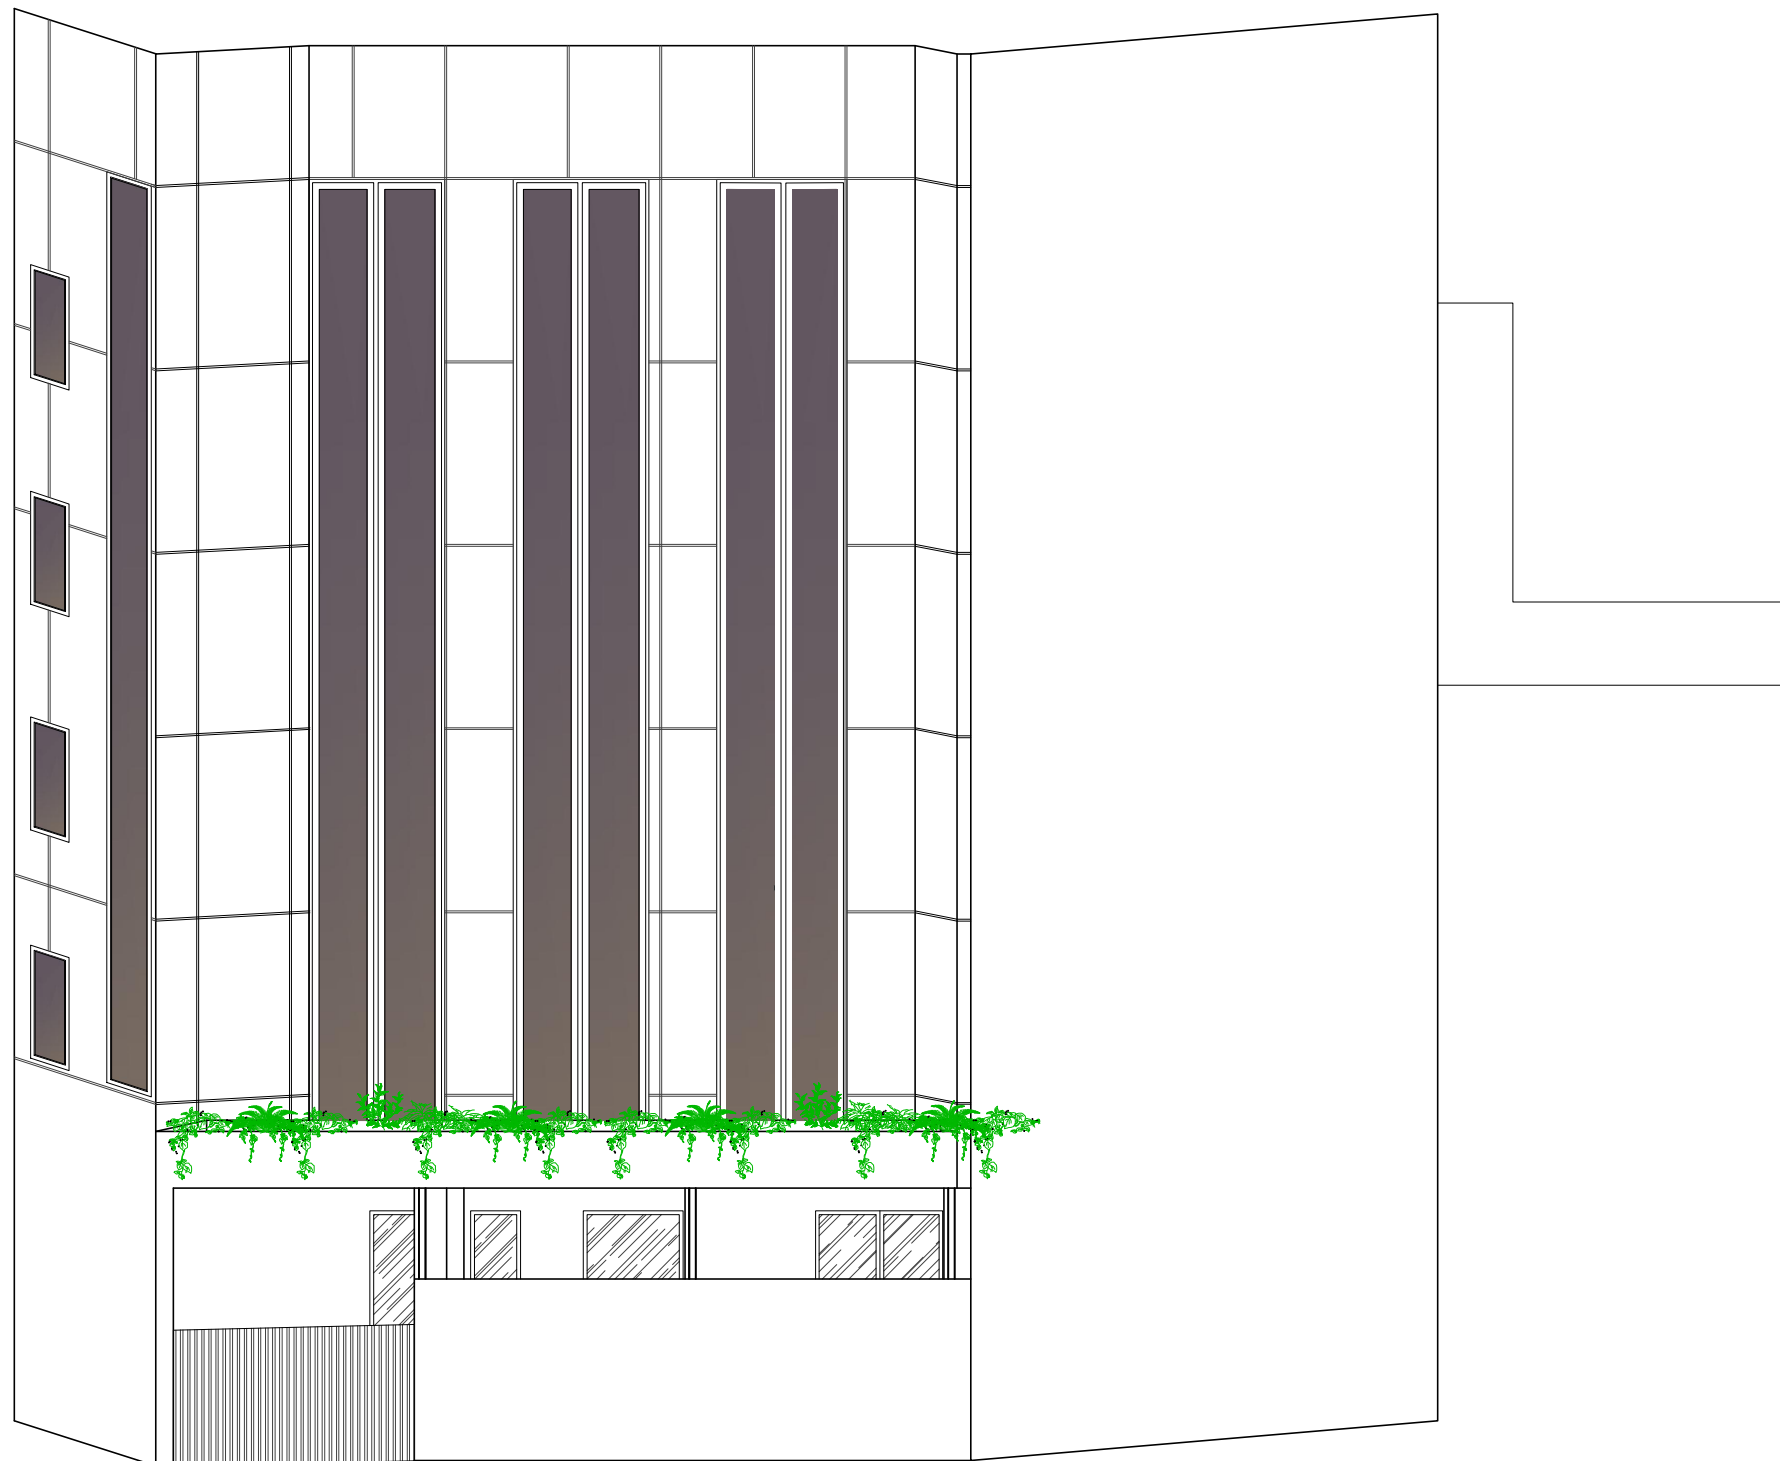

REAR SIDE ELEVATION
SCALE - 1 : 100

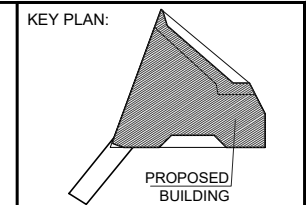

GENERAL NOTES :

ALL DIMENSIONS ARE IN MILLIMETERS UNLESS OTHERWISE MENTIONED.

NO DIMENSIONS TO BE SCALED OFF FROM DRAWINGS ONLY WRITTEN DIMENSIONS TO BE FOLLOWED.

IN THE EVENT OF ANY DISCREPANCIES OR DIFFERENCE BETWEEN ANY ARCHITECTURAL DRAWINGS AND STRUCTURAL DRAWINGS OR OTHER ENGINEERING DRAWINGS OR SITE CONDITIONS OR OTHERWISE IMMEDIATE REFERENCE IS TO BE MADE TO THE ARCHITECT FOR CLARIFICATION PRIOR TO EXECUTION OF WORK AT SITE.

PROJECT TITLE :

**PROPOSED
REFURBISHMENT
BUILDING**

CLIENT :

PEOPLE'S & FINANCE PLC
No.35/2D,
WELIMADA ROAD,
BANDARAWELA.

PROJECT DESIGN :

**PREMIER ENTRANCE
TECHNOLOGIES (PVT)LTD,**
No. 159/7/A,
KOSGAHAHENA JUNCTION,
PANNIPITIYA.
Tel : +94 112 851 729
Mobile : +94 713 270 996 /
+94 778 144 551
Web : www.premierentrance.com
Email : info@premierentrance.com

- ☐ A-APPROVED
- ☐ B-APPROVED AS COMMENTED
- ☐ C-REVISE & RESUBMIT
- ☐ D-FOR INFORMATION

AUTHORIZED SIGNATURE

DATE :

△		
△		
REV. NO.	BRIEF DESCRIPTION	DATE
----------	-------------------	------

REFERENCE DRAWINGS	


DRAWING TITLE:

REAR SIDE ELEVATION

SHOP DRAWINGS

Scale: AS SHOWN A3	Drawn by: SANDUN	Checked by: PET	Approved by: CLIENT
-----------------------	---------------------	--------------------	------------------------

DATE : 13-06-2026	DRAWING NO.: PET-AR-SPD-2026-08-11	REV. 0
----------------------	---------------------------------------	-----------

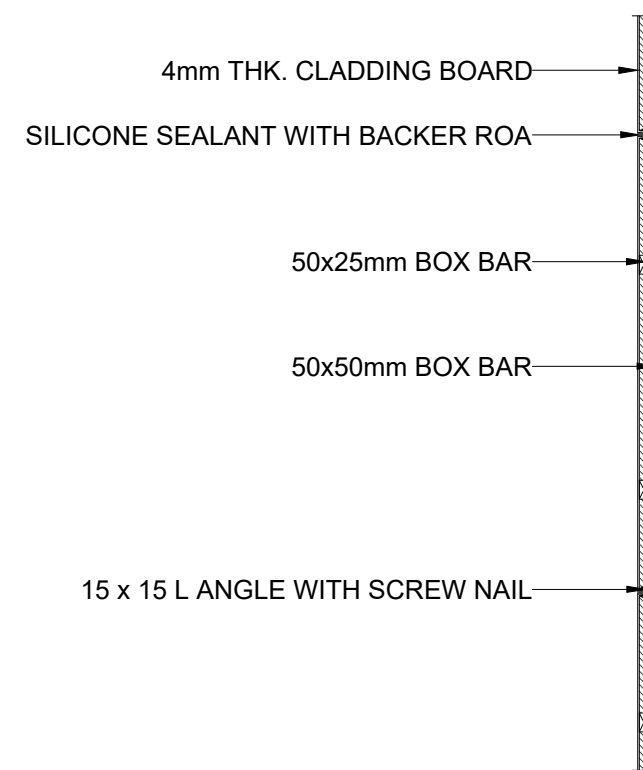

SCALE - 1 : 100

SCALE - 1 : 20

PLAN:

PROPOSED
BUILDING

IN THE EVENT OF ANY DISCREPANCIES OR DIFFERENCE BETWEEN ANY ARCHITECTURAL DRAWINGS AND STRUCTURAL DRAWINGS OR OTHER ENGINEERING DRAWINGS OR SITE CONDITIONS OR OTHERWISE IMMEDIATE REFERENCE IS TO BE MADE TO THE ARCHITECT FOR CLARIFICATION PRIOR TO EXECUTION OF WORK AT SITE

PROPOSED
REFURBISHMENT
BUILDING



No.35/2D,
WELIMADA ROAD,
BANDARAWELA.



Web : www.premierentrance.com
Email : info@premierentrance.com

AUTHORIZED SIGNATURE

	-	-
	-	-
REFERENCE DRAWINGS	
-	-
-	-
-	-
-	-

SECTION X - X

SHOP DRAWINGS

DATE :	DRAWING NO.:	REV.
13-06-2026	PET-AR-SPD-2026-08-12	0

